
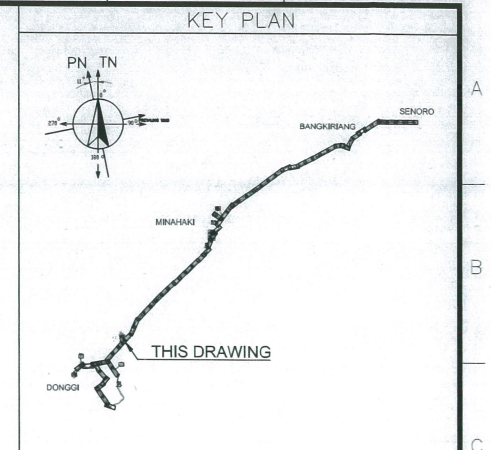


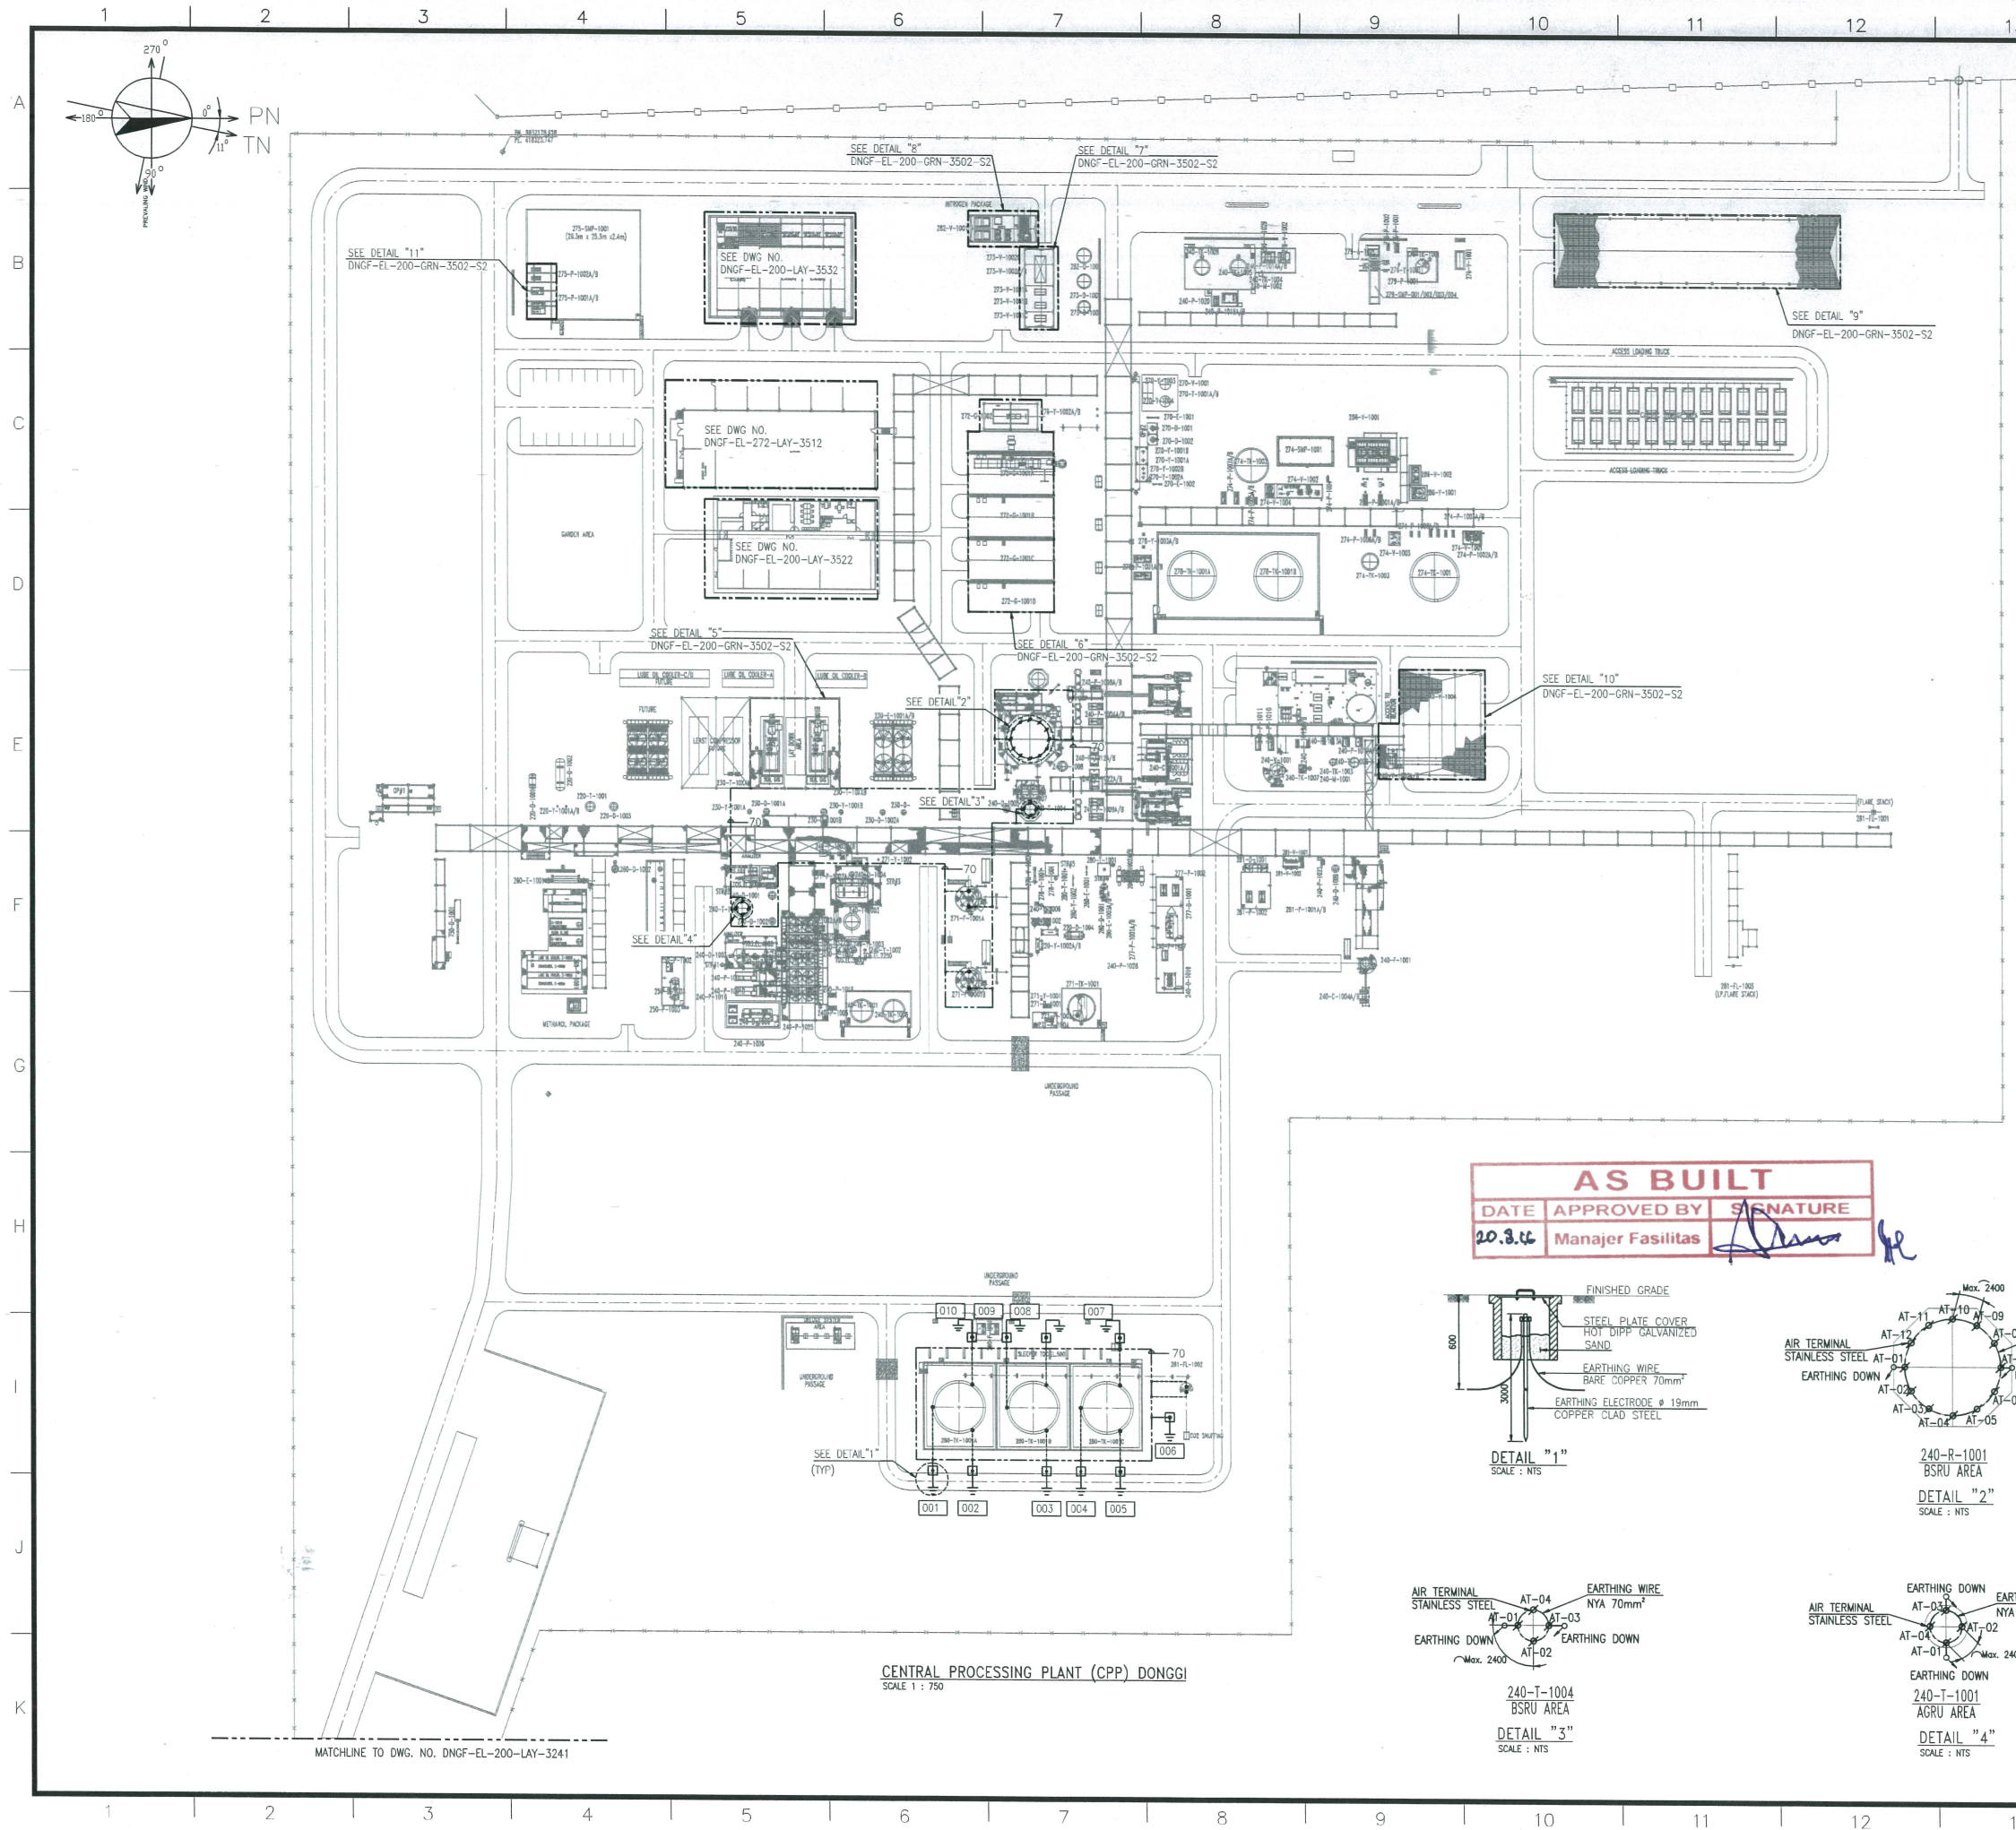

- NOTES
1. ALL DIMENSIONS ARE IN MILLIMETRES UNLESS OTHERWISE NOTED.
 2. MAXIMUM DISTANCE BETWEEN AIR TERMINAL ON TANK/COLUMN SHALL LESS THAN 2.4 m.

LEGENDS	
SYMBOL	DESCRIPTION
	EARTHING ELECTRODE C/W EARTHING WELL
	AIR TERMINAL C/W BASE PLATE
	UNDERGROUND EARTHING WIRE BARE COPPER SIZE 70mm²
	TAP EARTHING WIRE PVC INSULATED SIZE NYA 70mm²
	ABOVEGROUND EARTHING WIRE PVC INSULATED SIZE NYA 70mm²
	EARTHING WIRE CONNECTOR ("C" SLEEVE COMPRESSION TYPE)
	EARTHING DOWN
	CONNECTION POINT

DNGF-EL-900-STD-1501	STANDARD DRAWING FOR EARTHING & LIGHTNING PROTECTION SYSTEM					
DNGF-PP-900-LAY-1001	PLOT PLAN FOR CPP AREA - DONGGI					
DNGF-EL-900-CAL-1501	EARTHING & LIGHTNING PROTECTION CALCULATION					
DOC. NO.	TITLE					
REFERENCE DRAWING						
23/03/16 AS BUILT	SRM/AET/MI/ITM					
05/12/14 ISSUED FOR CONSTRUCTION	IH/IH/AET/TGS/RA/TM					
07/10/14 ISSUED FOR APPROVAL	IH/IH/AET/TGS/MIRA/TM					
26/08/14 ISSUED FOR REVIEW	IH/IH/AET/TGS/MIRA/TM					
22/08/14 ISSUED FOR INTERNAL REVIEW	IH/IH/AET/TGS/MIRA/YC					
REV.	ISSUE DATE	DESCRIPTION	DRAWN	DSGN	CHKD	APVD

REVISIONS		
REV.	DATE	APPROVED

CLIENT APPROVAL

THIS DRAWING EMBODIES PROPRIETARY INFORMATION OF PT. REKAYASA INDUSTRI. THIS DRAWING OR THE MATERIAL DESCRIBED THEREIN MAY NOT BE COPIED OR DISCLOSED IN ANY FORM OR MEDIUM TO THIRD PARTIES, OR USED FOR OTHER THAN THE PURPOSE FOR WHICH IT HAS BEEN PROVIDED, IN WHOLE OR IN PART IN ANY MANNER EXCEPT AS EXPRESSLY PERMITTED BY PT. REKAYASA INDUSTRI.

CLIENT

skkmigas PERTAMINA EP

CONTRACTOR

PT. REKAYASA INDUSTRI
ENGINEERING & CONSTRUCTION
JAKARTA - INDONESIA

PROYEK PENGEMBANGAN GAS MATINDOK (PPGM)
PEMBANGUNAN FASILITAS PRODUKSI GAS DONGGI

TITLE

LIGHTNING PROTECTION LAYOUT
FOR
DONGGI GAS PRODUCTION FACILITY (1/2)

SCALE : AS SHOWN JOB NO. : 12-1608

CONTRACTOR DRAWING NO. REV.

DNGF-EL-200-LAY-3502-S1

CAD. No DNGF-EL-200-LAY-3502-S1-R4